



DO NOT SCALE

ALL DIMENSIONS SHOULD BE CHECKED PRIOR TO COMMENCEMENT OF CONSTRUCTION

THIS DRAWING IS COPYRIGHT AND MAY NOT BE REPRODUCED WITHOUT THE TRUST'S CONSENT

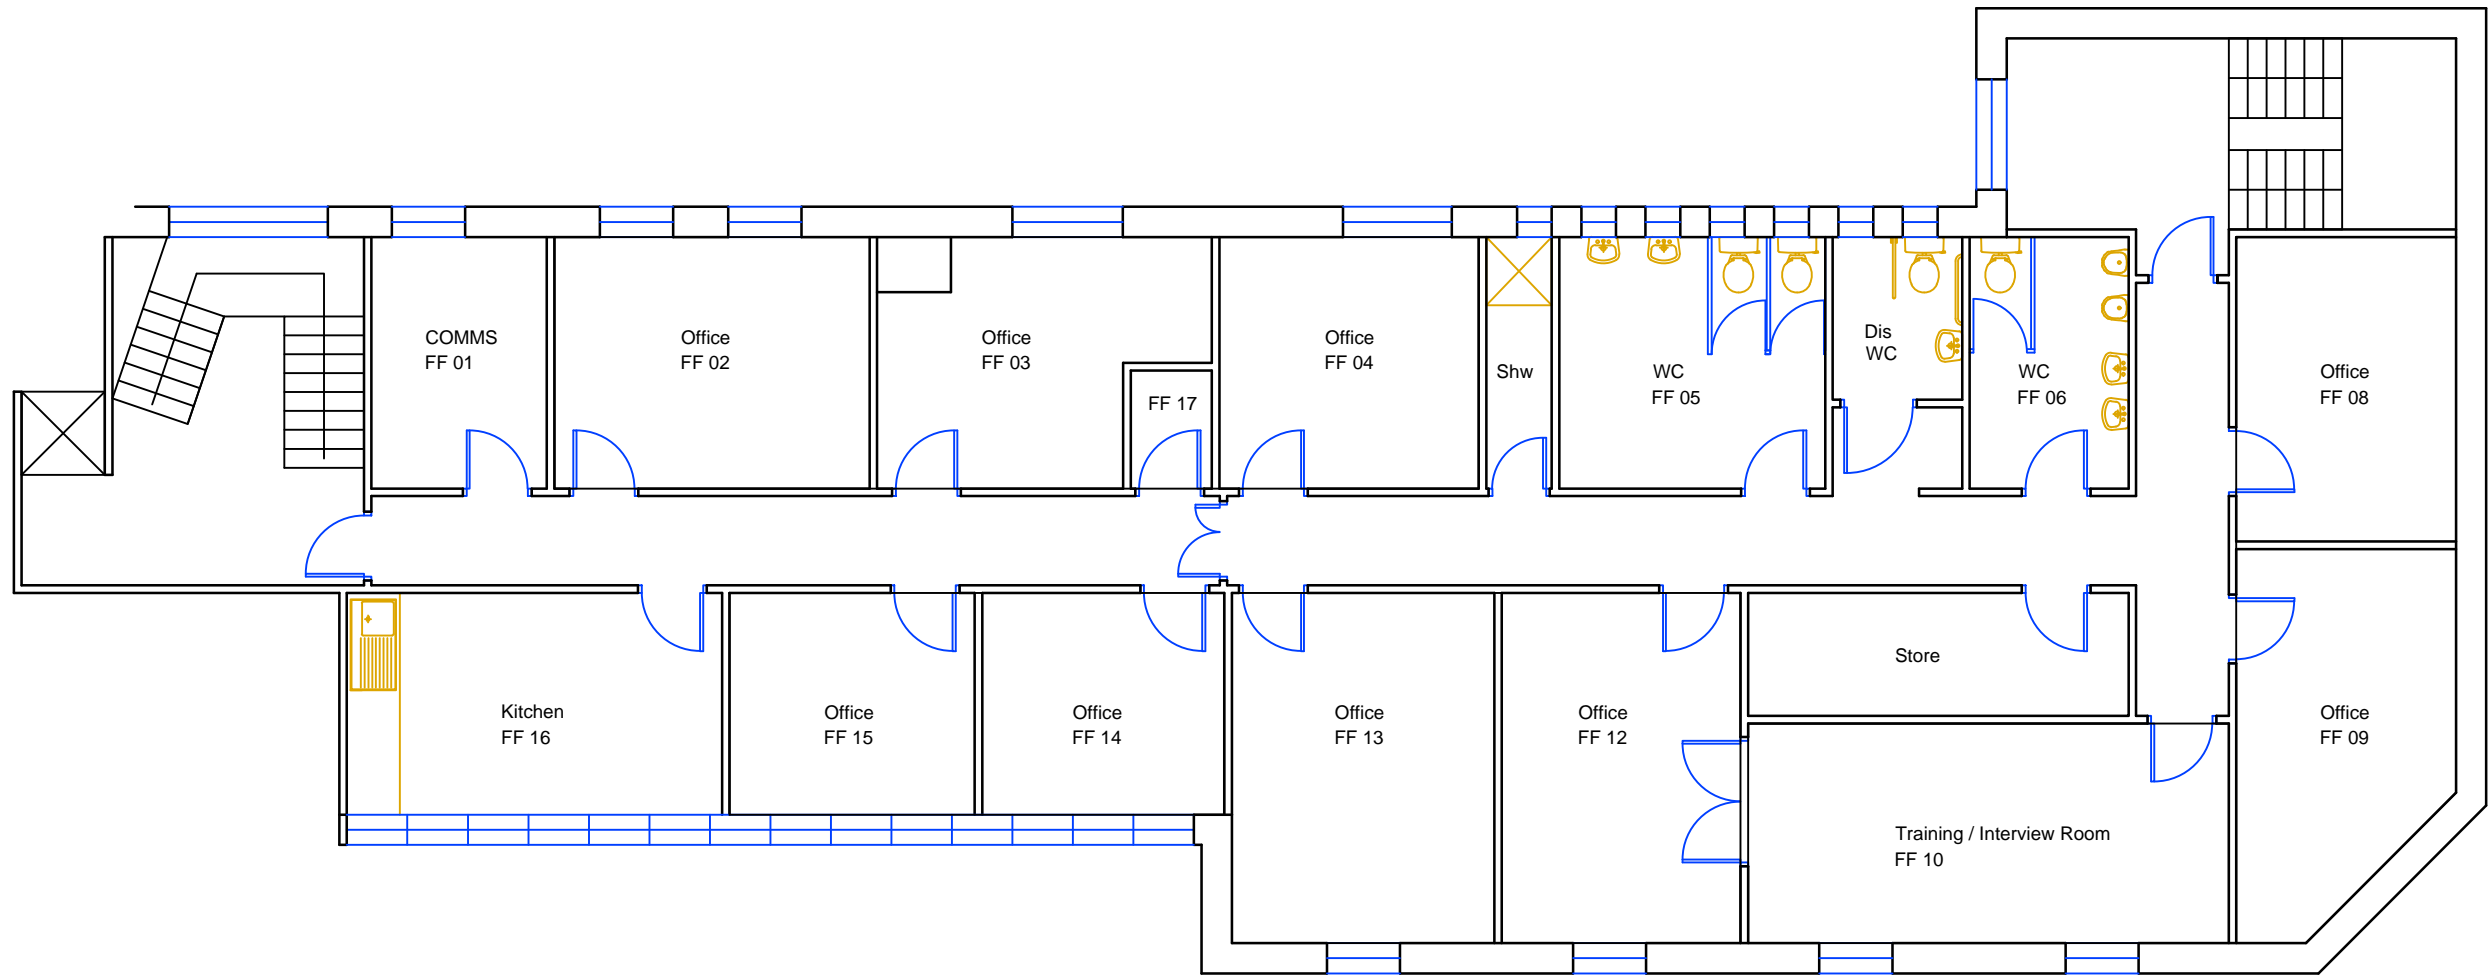

FIRST FLOOR PLAN

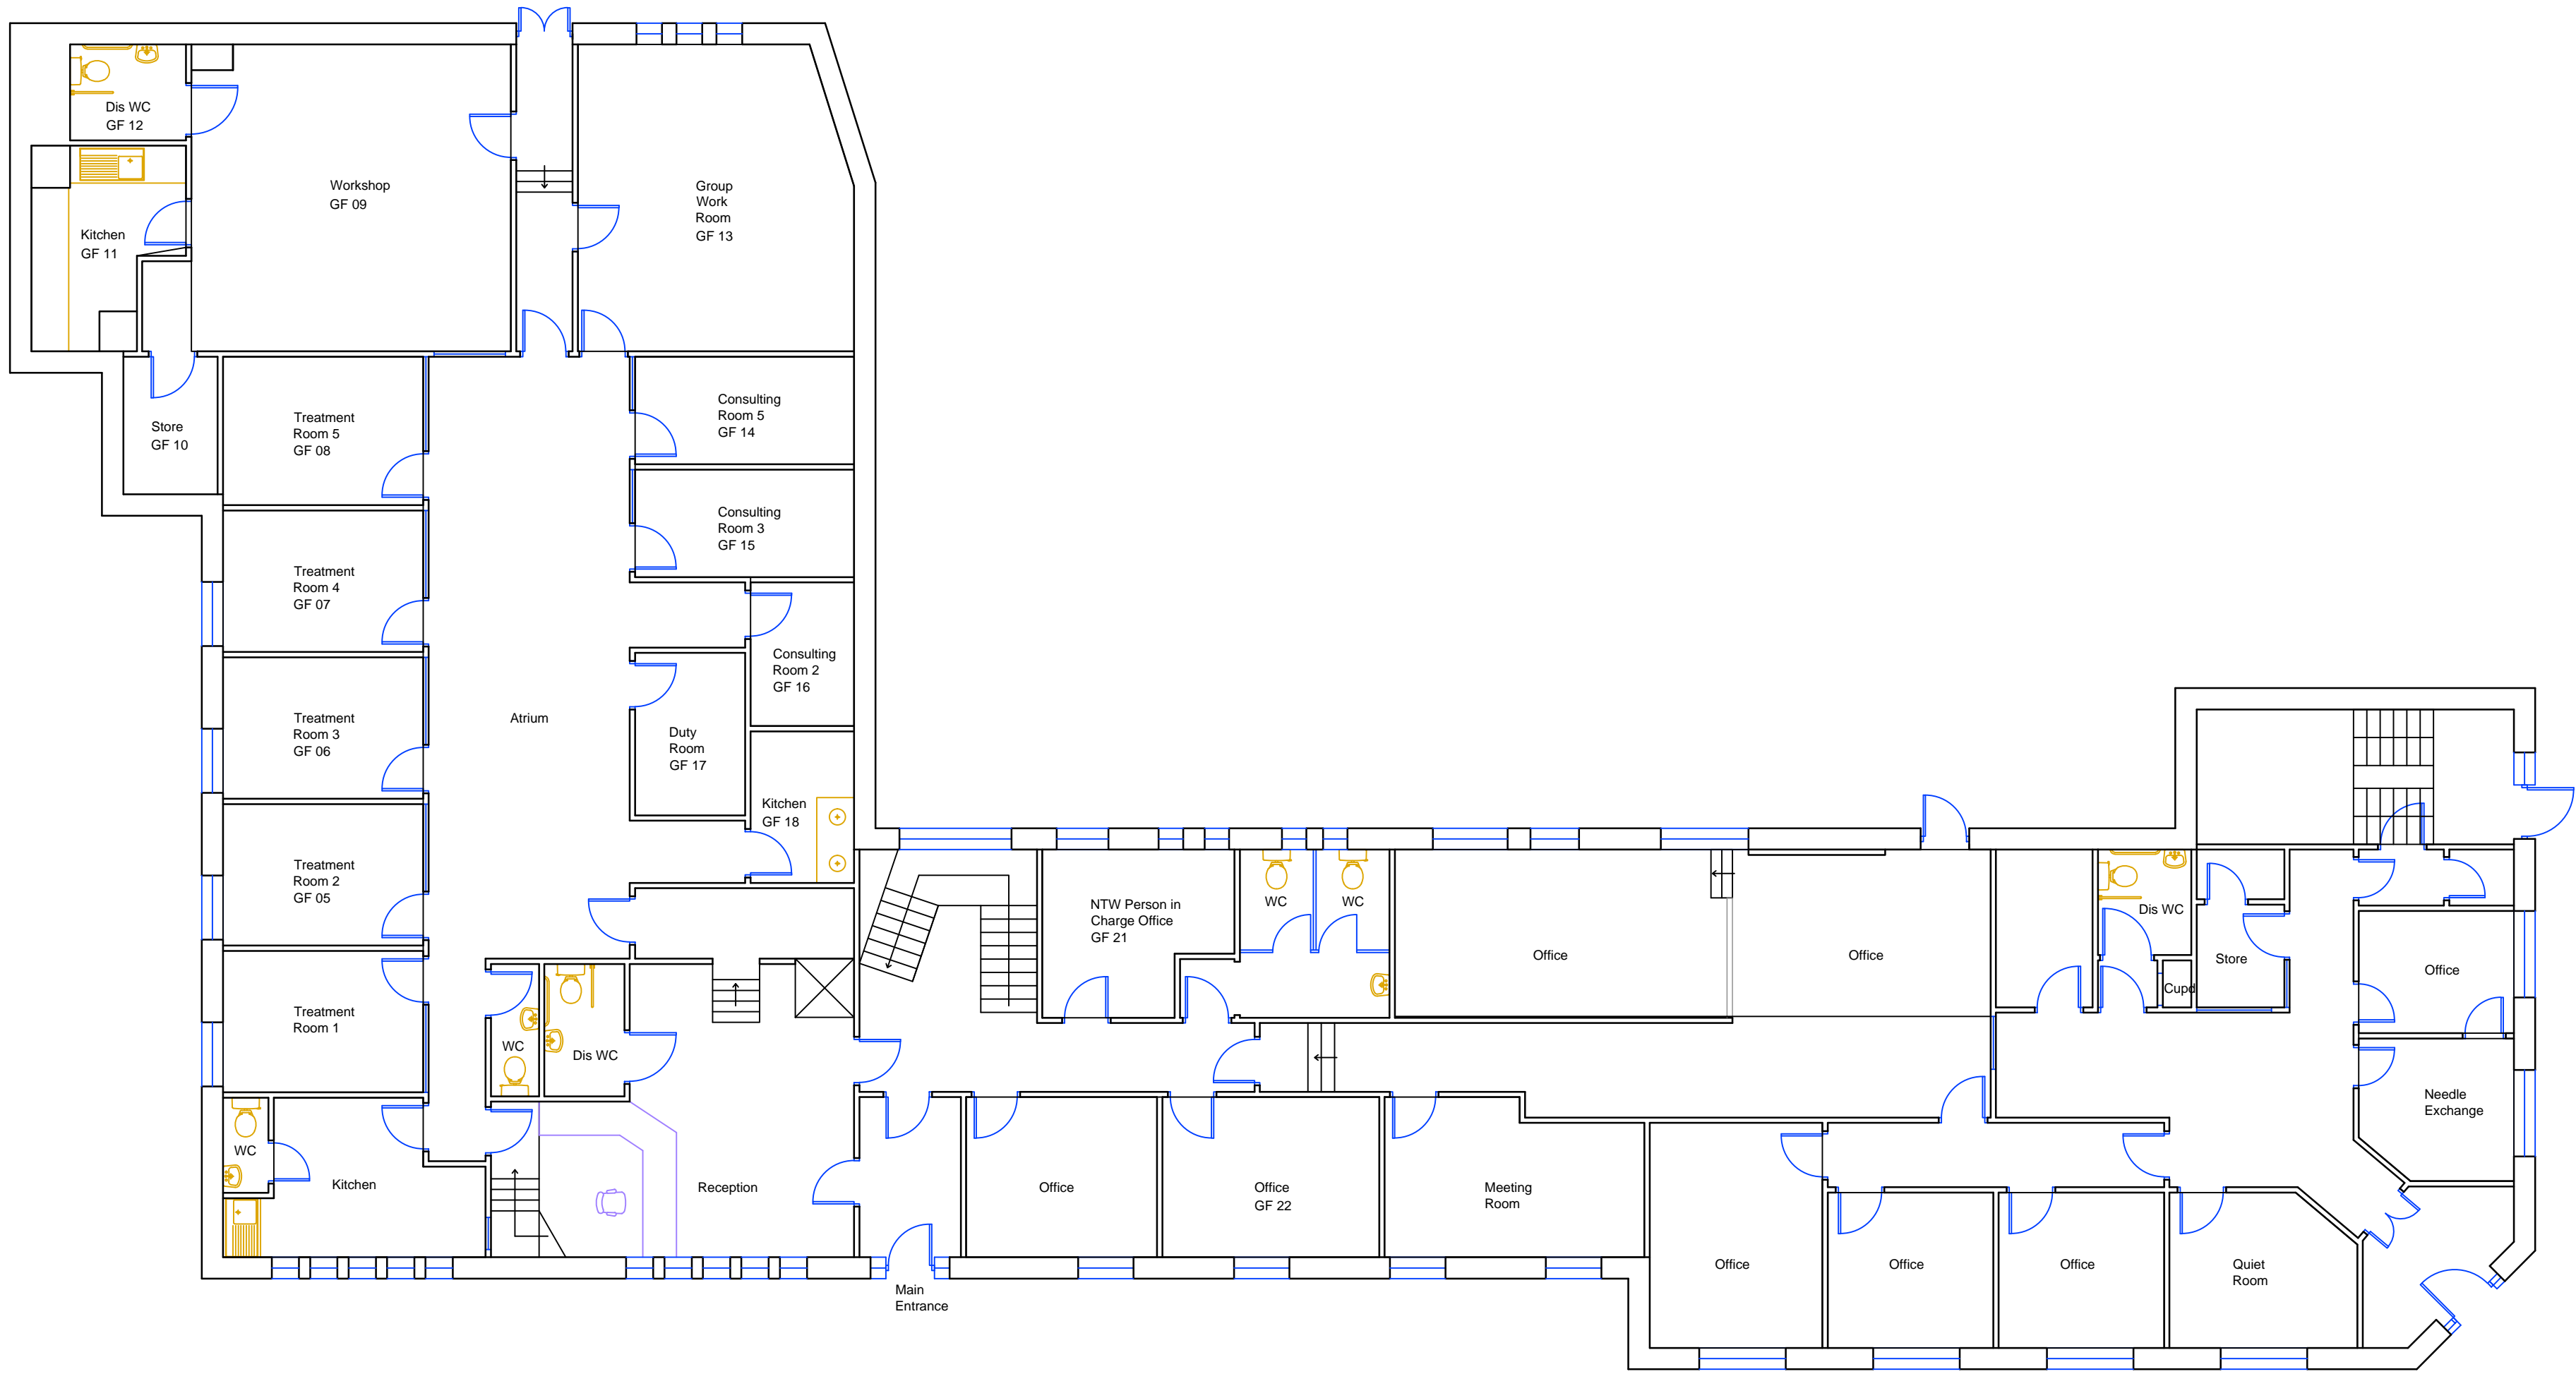

GROUND FLOOR PLAN

Rev:	Description:	Date:	By:
LOCATION Project Answer Atkinson Terrace Wallsend Tyne & Wear NE28 6SS			
TITLE Ground & First Floor Layout Plans			
 NTW Solutions St. Nicholas Hospital Jubilee Road Gosforth Newcastle Upon Tyne NE3 3XT Tel: 0191 2232209 Fax: 0191 2232242			
SCALE 1:100 @ A1	DATE 02-05-17	DRAWN BY SJM	
STATUS AS BUILT		CHECKED BY -	
DRAWING No. 893-00-00-201		REVISION -	